

REMARKS

The claims pending in this patent application following amendment are newly presented Claims 9-14, inclusive. Each of original Claims 1-8 has been cancelled, without prejudice.

Claims 1-3 and 7 are rejected under 35 U.S.C. 103 as being unpatentable over the patent to Allman et al (5,465,438) in view of the patent to Watkins et al (5,813,063). Claims 4-6 and 8 are rejected under 35 U.S.C. 102(b) as being anticipated by the aforementioned patent to Watkins et al. Inasmuch as each of original Claims 1-8 has been cancelled, these rejections are now rendered moot.

Claims 9-14 are presented for the first time to more clearly set forth the applicant's claimed invention. In particular, newly presented Independent Claim 9 recites a portable water dispensing station comprising a fluid coupling adapted to receive fresh water from an external water source that is located remotely from the portable water dispensing station, a reservoir for storing fresh water that is movable with the portable water dispensing station, a water pump, and a control valve by which to selectively connect the water pump to either the fluid coupling (so as to receive fresh water from the external water source) or to the reservoir (so as to receive fresh water that is stored therewithin and carried by the portable water dispensing station) depending upon the operation of the control valve. That is to say, when the control valve is moved to a first (i.e., open) position, the water pump is connected to the fluid coupling so that a hose, or the like, can provide fresh water to the faucet from an external water source. However, when the control valve is moved to a second (i.e., closed) position, the water pump is otherwise connected to the portable reservoir so that the

fresh water that is transported with the portable water dispensing station can be provided to the faucet.


There is nothing shown or suggested in either the patent to Watkins et al or any reasonable combination of Allman et al in view of Watkins et al which is the same or equivalent to the applicant's portable water dispensing station as recited in newly presented Independent Claim 9 comprising a control valve which is selectively operated to connect a water pump to one of a fluid coupling to be supplied from an external water source or to a reservoir to be supplied from an internal (i.e., portable) water source. It may be that Allman discloses a portable water dispensing station adapted to be independently connected to receive fresh water from an external water source and from an internal water reservoir. However, there is nothing shown or suggested in Allman et al or Watkins et al to also include a control valve by which a fluid pump is selectively connected to either the external water source or to the internal water reservoir by means of operating the control valve (i.e., between open and closed positions). Accordingly, it is submitted that newly presented Independent Claim 9 is distinguishable from Watkins et al or Allman et al in view of Watkins et al. Inasmuch as Independent Claim 9 is believed to be patentable, each of newly presented Claims 10-14, which depends therefrom, is likewise believed to be patentable.

In view of the foregoing, each of Claims 9-14 which now appears in this patent application is believed to recite a patentable portable water dispensing station. Therefore, reconsideration of the Examiner's rejection is requested and a Notice of Allowance is earnestly solicited.

Attached hereto are four pages of drawings with proposed corrections indicated thereon in red ink. The proposed corrections to the drawings are to add additional reference numerals so as to enable the drawings to better correspond with a reading of the applicant's specification. Moreover, extraneous matter (e.g., bill of materials, dimension lines, drawing designators, and the like) have been deleted so as to place the drawings in better form for publication. However, it is pointed out that no new matter has been added and the scope of the claimed invention has not been changed. Accordingly, it is requested that the aforementioned corrections be approved in toto.

A power of attorney is also attached to enable the undersigned attorney to prosecute this application and to file this Amendment on behalf of the applicant.

Respectfully submitted,

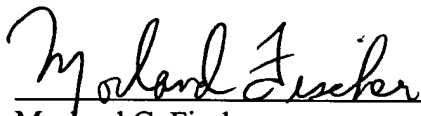

Morland C. Fischer
Attorney for the applicant
2030 Main Street, Suite 1050
Irvine, California 92614
Telephone (949) 476-0600
Facsimile (949) 476-0606

November 6, 2003
Dated

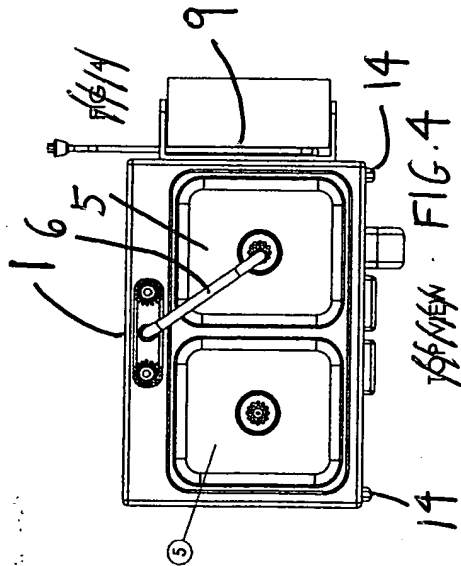


FIG. 4
TOP VIEW

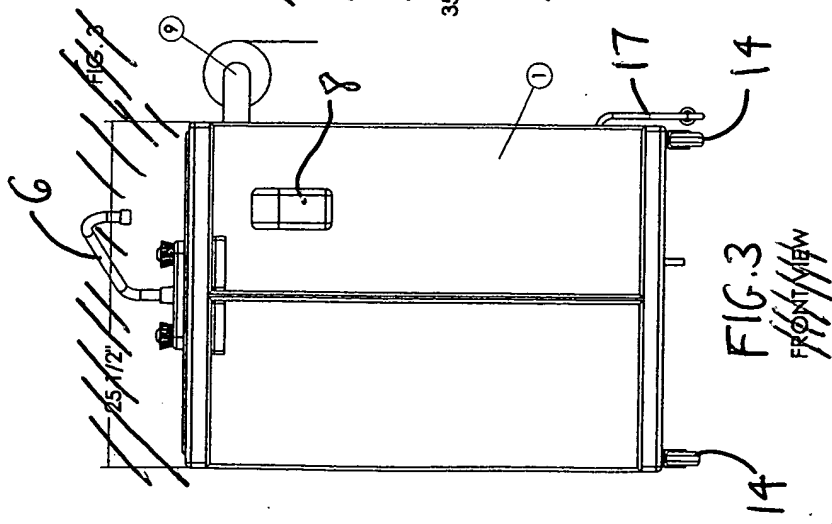


FIG. 3
FRONT VIEW

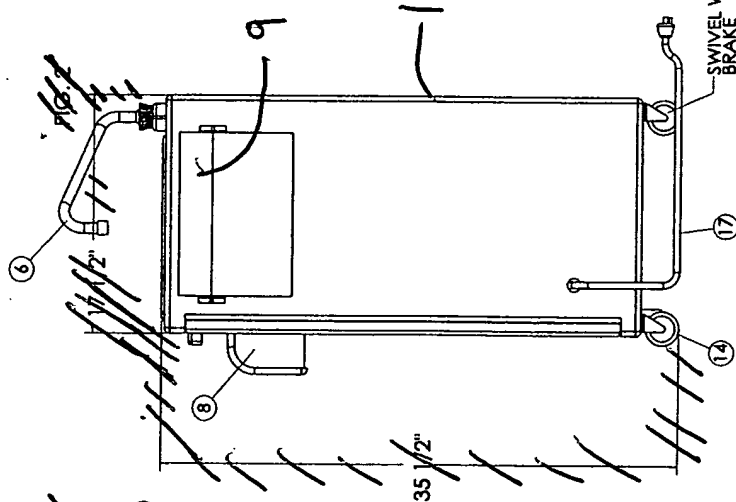


FIG. 2
RIGHT SIDE VIEW


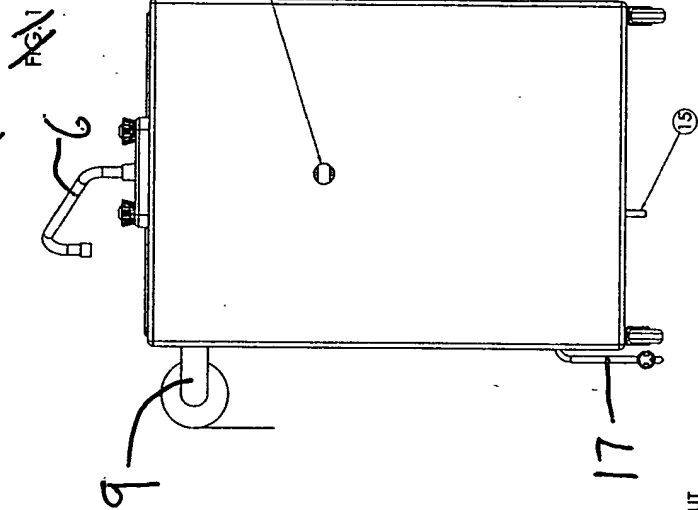


FIG. 1
BACK VIEW

QTY	PART OR IDENTIFYING NO.	DESCRIPTION OR DISCREPTION	MATERIAL SPECIFICATION
1	1	ELECTRIC CORD	PLASTIC
2	2	TEE FITTING	PLASTIC
1	3	OVERFLOW TUBE	PLASTIC
4	4	WHEELS	PLASTIC
1	5	CHECK VALVE	PLASTIC
1	6	BALL VALVE	PLASTIC
1	7	CONNECTION, GARDEN HOSE	PLASTIC
2	8	TANKS	PLASTIC
1	9	TOWEL HOLDER	PLASTIC
1	10	SOAP DISPENSER	PVC
1	11	DRAIN SYSTEM	PVC
1	12	FAUCET	STAINLESS STEEL
1	13	SINK	STAINLESS STEEL
1	14	GFI OUTLET WITH SWITCH	STAINLESS STEEL
1	15	WATER PUMP	STAINLESS STEEL
1	16	WATER HEATER, ELECTRIC	STAINLESS STEEL
1	17	CABINET WITH DOORS	PLASTIC

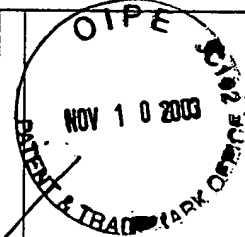

MONSIEUR ENTERPRISES 1430 CRESCENT DRIVE FARMINGTON, CT 06031 (861) 272-2404 www.portablenk.com	
TITLE: PORTABLE SINK PATENT DRAWING	
SHEET: 1 OF 3	DWG. NO.: PSE2000

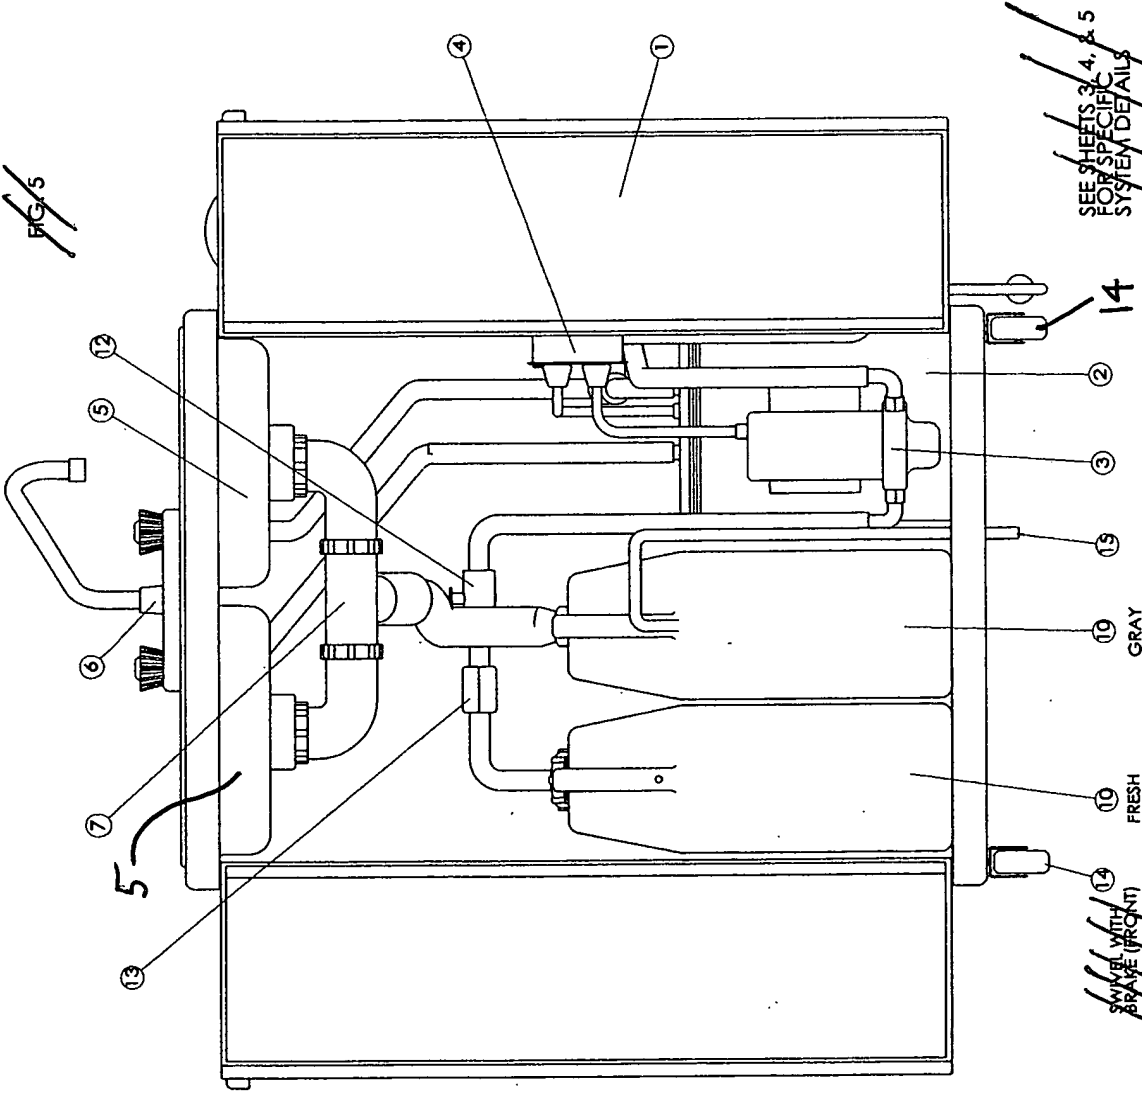


FIG. 5

SEE SHEETS 3, 4, & 5
FOR SPECIFIC
SYSTEM DETAILS

FRONT VIEW FIG. 5

SWIVEL WITH
BRAKE (FRONT)

MOUSAM ENTERPRISES 1123 CRECENT DRIVE BIRMINGHAM, AL 35213 Tel: (951) 200-1166 www.portabletrf.com	
TITLE	PORTABLE SINK PATENT DRAWING
SHEET	2 OF 5
DWG NO.	PSE2000

SEE SHEET FOR PARTS LIST

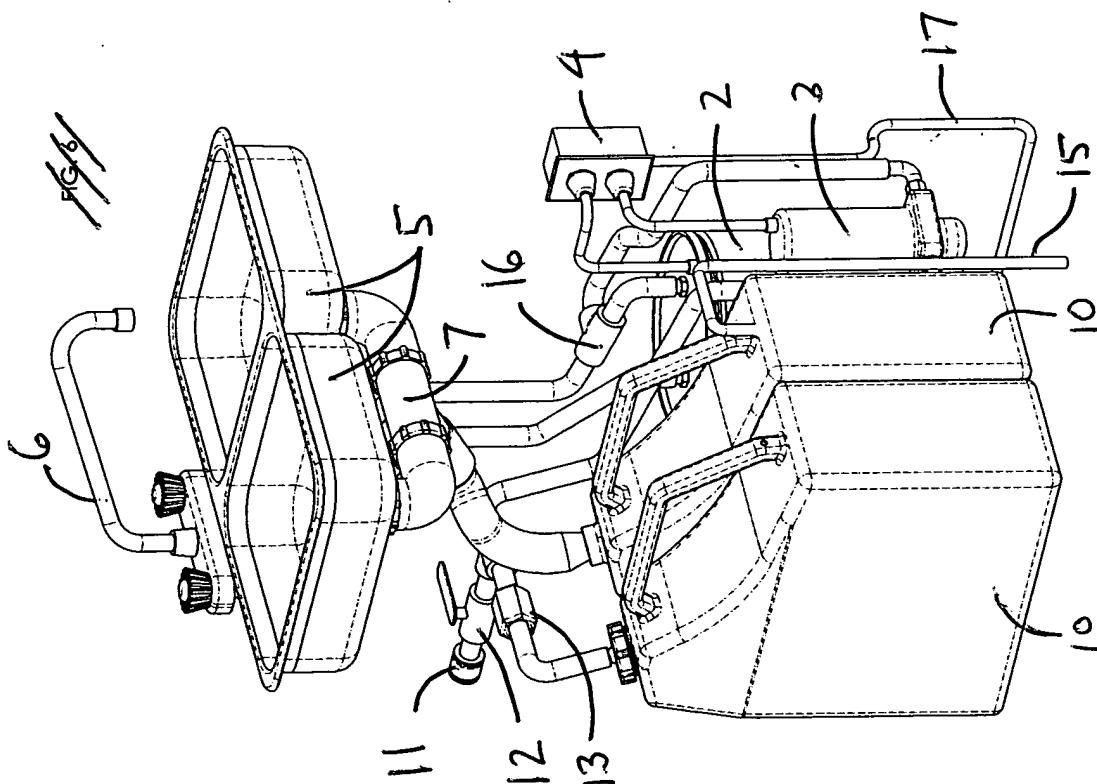
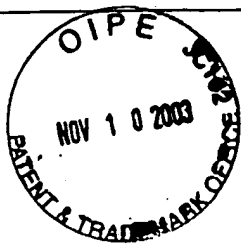


FIG. 6
PORTABLE SINK SYSTEM CONSISTING OF:
WATER DELIVERY SYSTEM, DRAIN SYSTEM,
& ELECTRICAL COMPONENTS (SEE SHEETS
4 & 5 FOR SYSTEM DESCRIPTIONS).

MONSAM ENTERPRISES 1125 CRESCENT DRIVE BRENTWOOD, CA 94513 tel: (925) 200-6162 www.psehabesink.com	
TITLE	PORTABLE SINK PATENT DRAWING
SHEET	3 OF 5
DWG. NO.	PSE2000

NOV 10 2003
 PATENT & TRADEMARK OFFICE

MONSAM ENTERPRISES
 11745 CRESCENT DRIVE
 BAYVIEW, CA 94033
 TEL (925) 230-6168 www.monsam.com

TITLE PORTABLE SINK PATENT DRAWING
 SHEET 4 of 5 DWG. NO. PSE2000

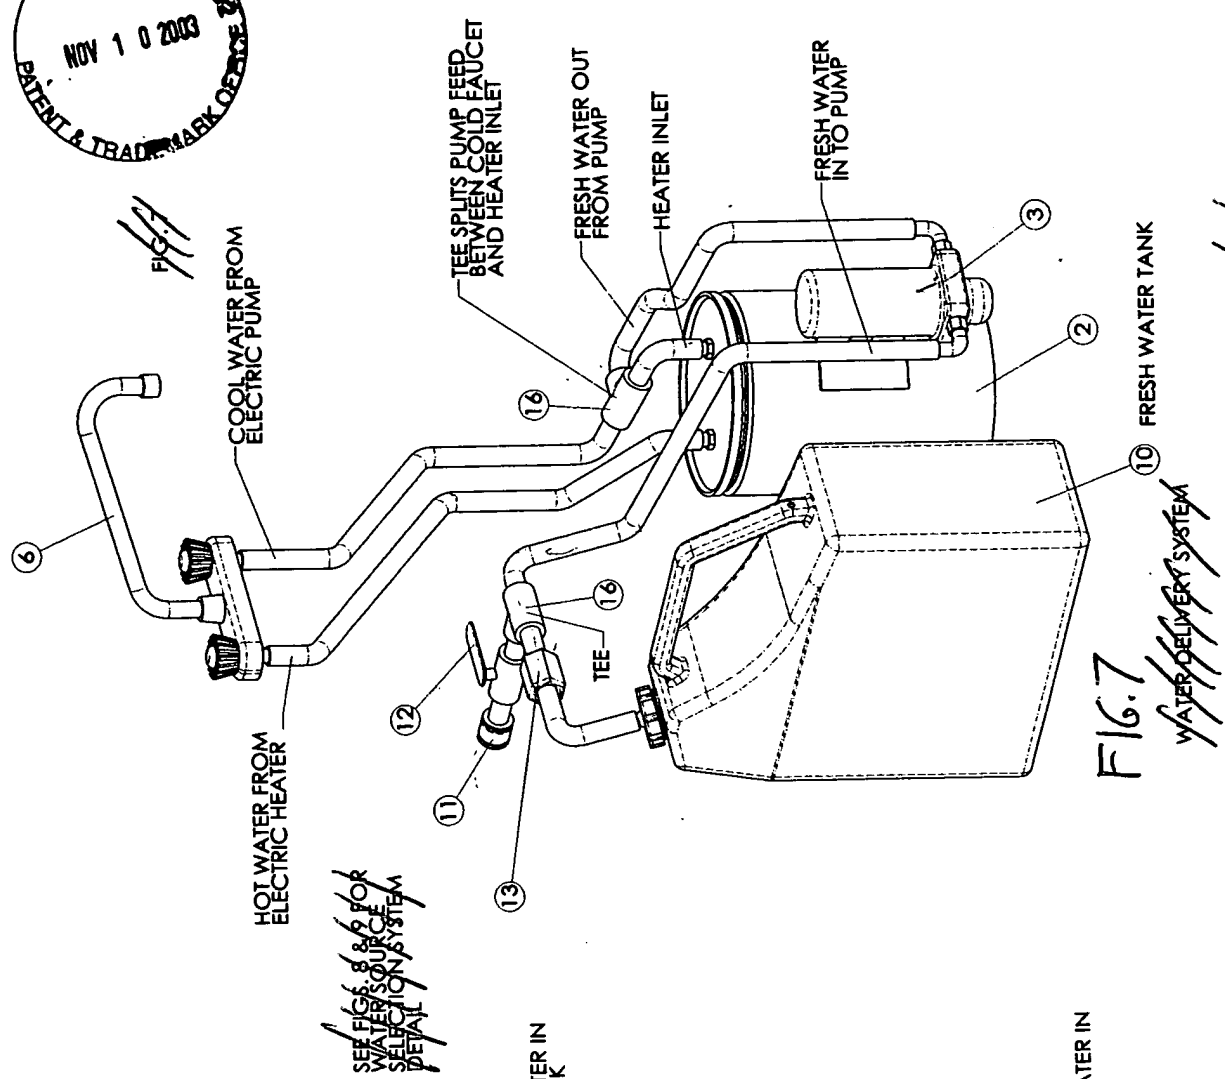


FIG. 7
 WATER DELIVERY SYSTEM

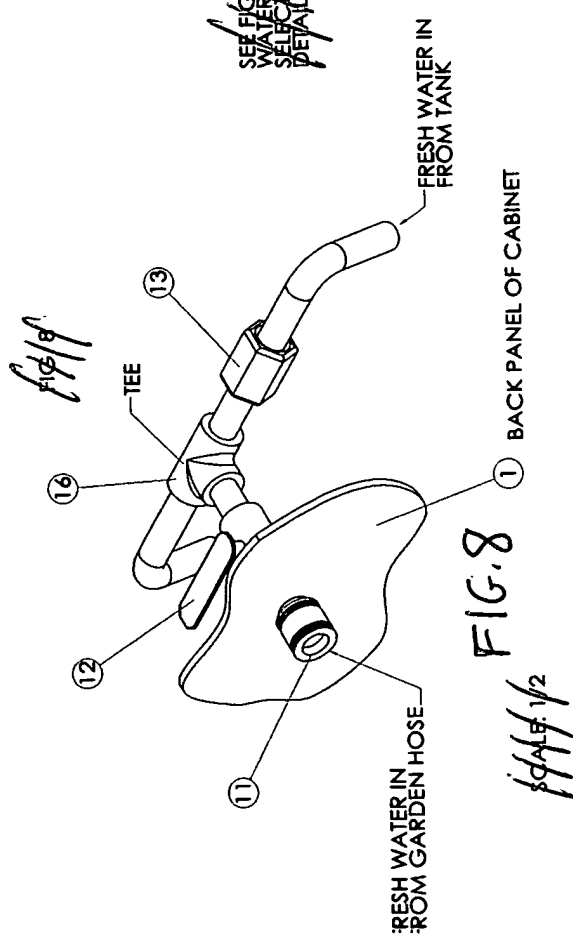


FIG. 8
 SCALE: 1/2

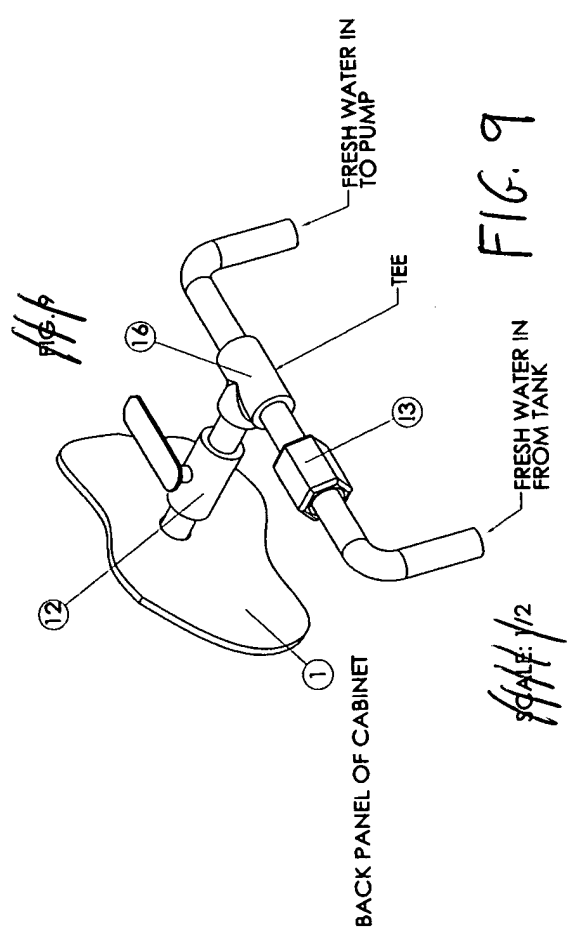


FIG. 9
 SCALE: 1/2

SEE SHEET FOR PARTS LIST



FIG. 11

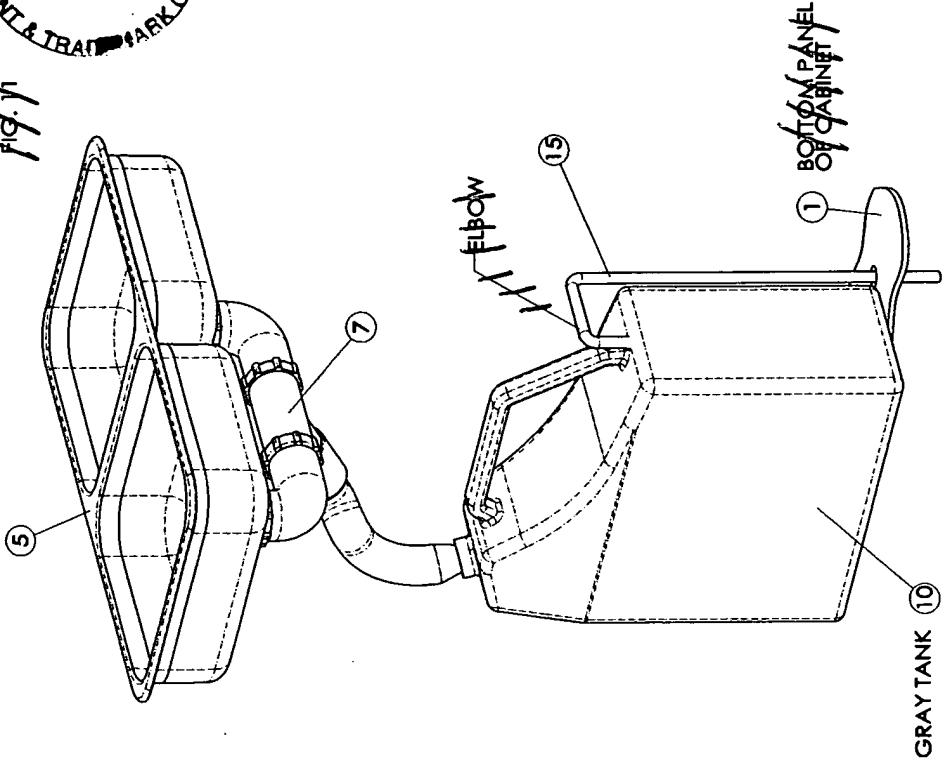


FIG. 11

DRAIN SYSTEM

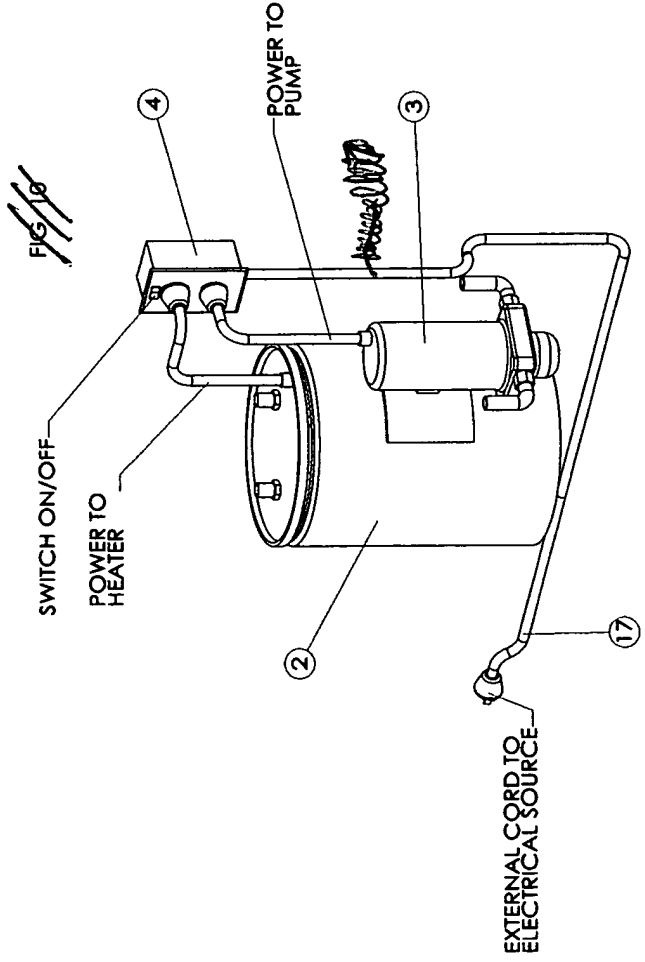


FIG. 10

ELECTRICAL COMPONENTS

MONSIEUR ENTERPRISES			
1125 CRESCENT DRIVE			
BRIGHTWOOD, CA 94513			
TEL (925) 240-4468			
WWW.PORTABLESINK.COM			
TITLE			
PORTABLE SINK/PATENT DRAWING			
SHEET 5 OF 5		Dwg. NO. PSE2000	

SEE SHEET 1 FOR PARTS LIST